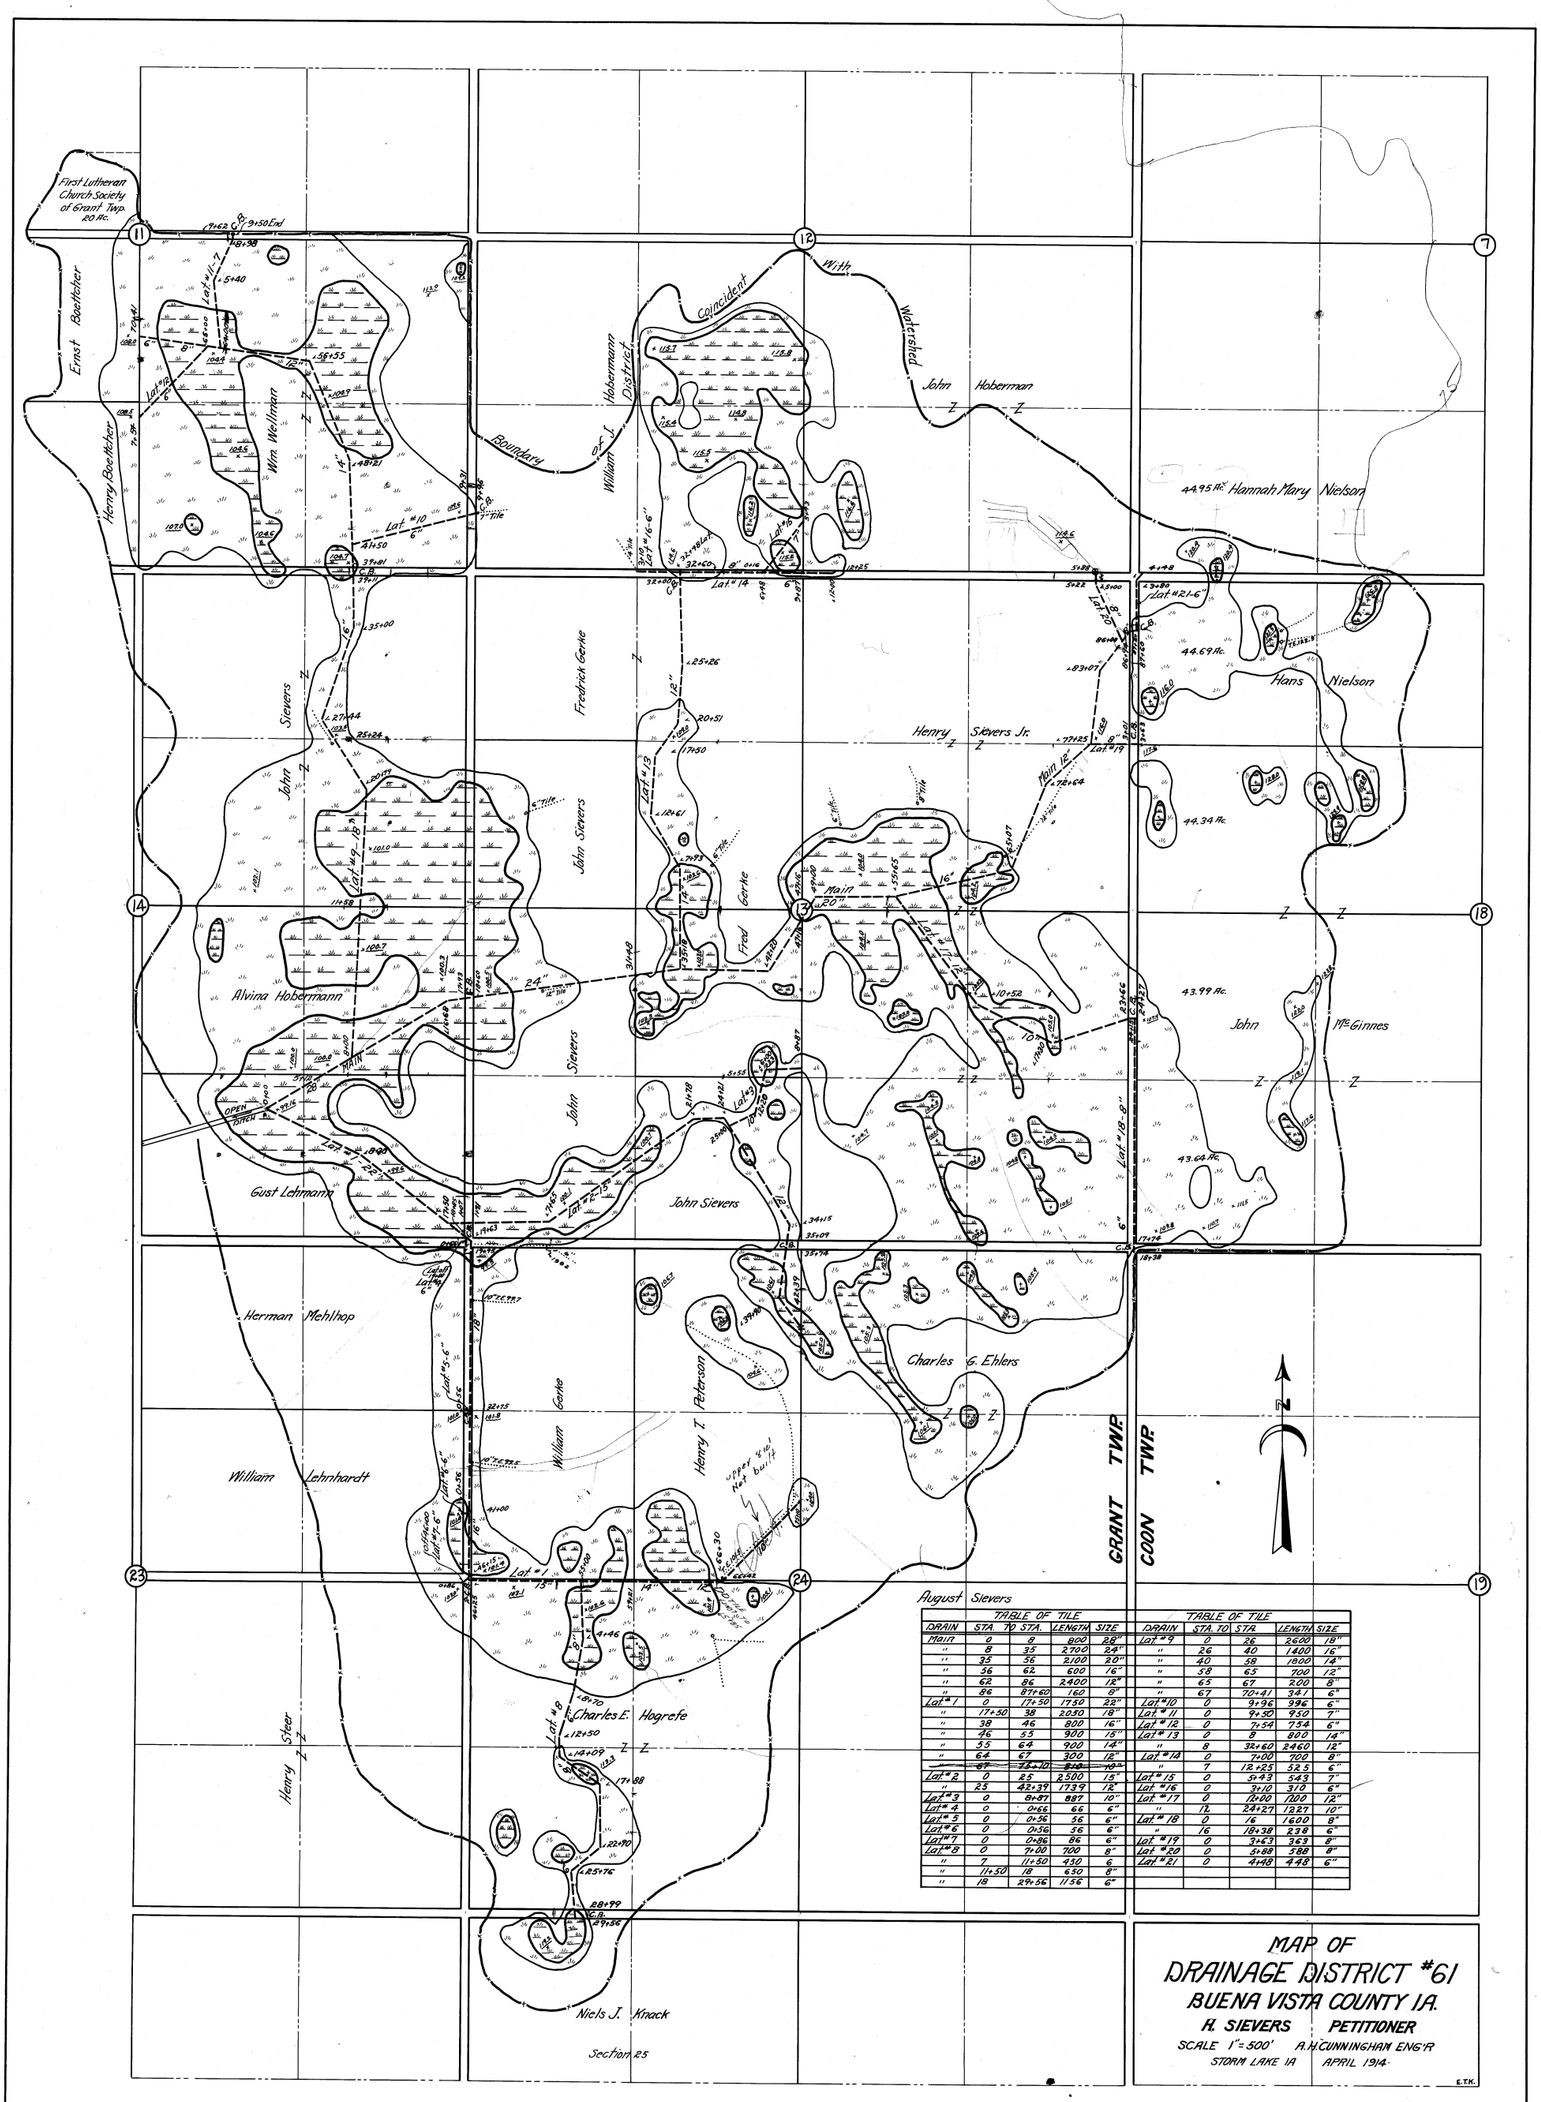

TABLE OF TILE					TABLE OF TILE				
DRAIN	STA.	TO STA.	LENGTH	SIZE	DRAIN	STA.	TO STA.	LENGTH	SIZE
Main	0	8	800	28"	Lat #9	0	26	2600	18"
"	8	35	2700	24"	"	26	40	1400	16"
"	35	56	2100	20"	"	40	58	1800	14"
"	56	62	600	16"	"	58	65	700	12"
"	62	86	2400	12"	"	65	67	200	8"
"	86	87+60	160	8"	"	67	70+41	341	6"
Lat #1	0	17+50	1750	23"	Lat #10	0	9+96	996	6"
"	17+50	38	2050	18"	Lat #11	0	9+50	950	7"
"	38	46	800	16"	Lat #12	0	7+54	754	6"
"	46	55	900	18"	Lat #13	0	8	800	14"
"	55	64	900	14"		8	32+60	2460	12"
"	64	67	300	12"	Lat #14	0	7+00	700	8"
~~"~~	~~87~~	~~92+10~~	~~510~~	~~10"~~	"	7	12+25	525	6"
Lat #3	0	8+87	887	10"	Lat #17	0	12+00	1200	12"
Lat #4	0	0+66	66	6"	"	12	24+27	1227	10"
Lat #5	0	0+56	56	6"	Lat #18	0	16	1600	8"
Lat #6	0	0+56	56	6"	"	16	18+38	238	6"
Lat #7	0	0+86	86	6"	Lat #19	0	3+63	363	8"
Lat #8	0	7+00	700	8"	Lat #20	0	5+88	588	8"
"	7	11+50	450	6"	Lat #21	0	4+48	448	6"
"	11+50	18	650	8"					
"	18	29+56	1156	6"					

MAP OF DRAINAGE DISTRICT #61

BUENA VISTA COUNTY IA.

H. SIEVERS PETITIONER

SCALE 1" = 500' A.H. CUNNINGHAM ENG'R

STORM LAKE IA APRIL 1914

E.T.K.